



Veritas Real Estate

807 Haddon Ave., Haddonfield, NJ 08033
11/06/20

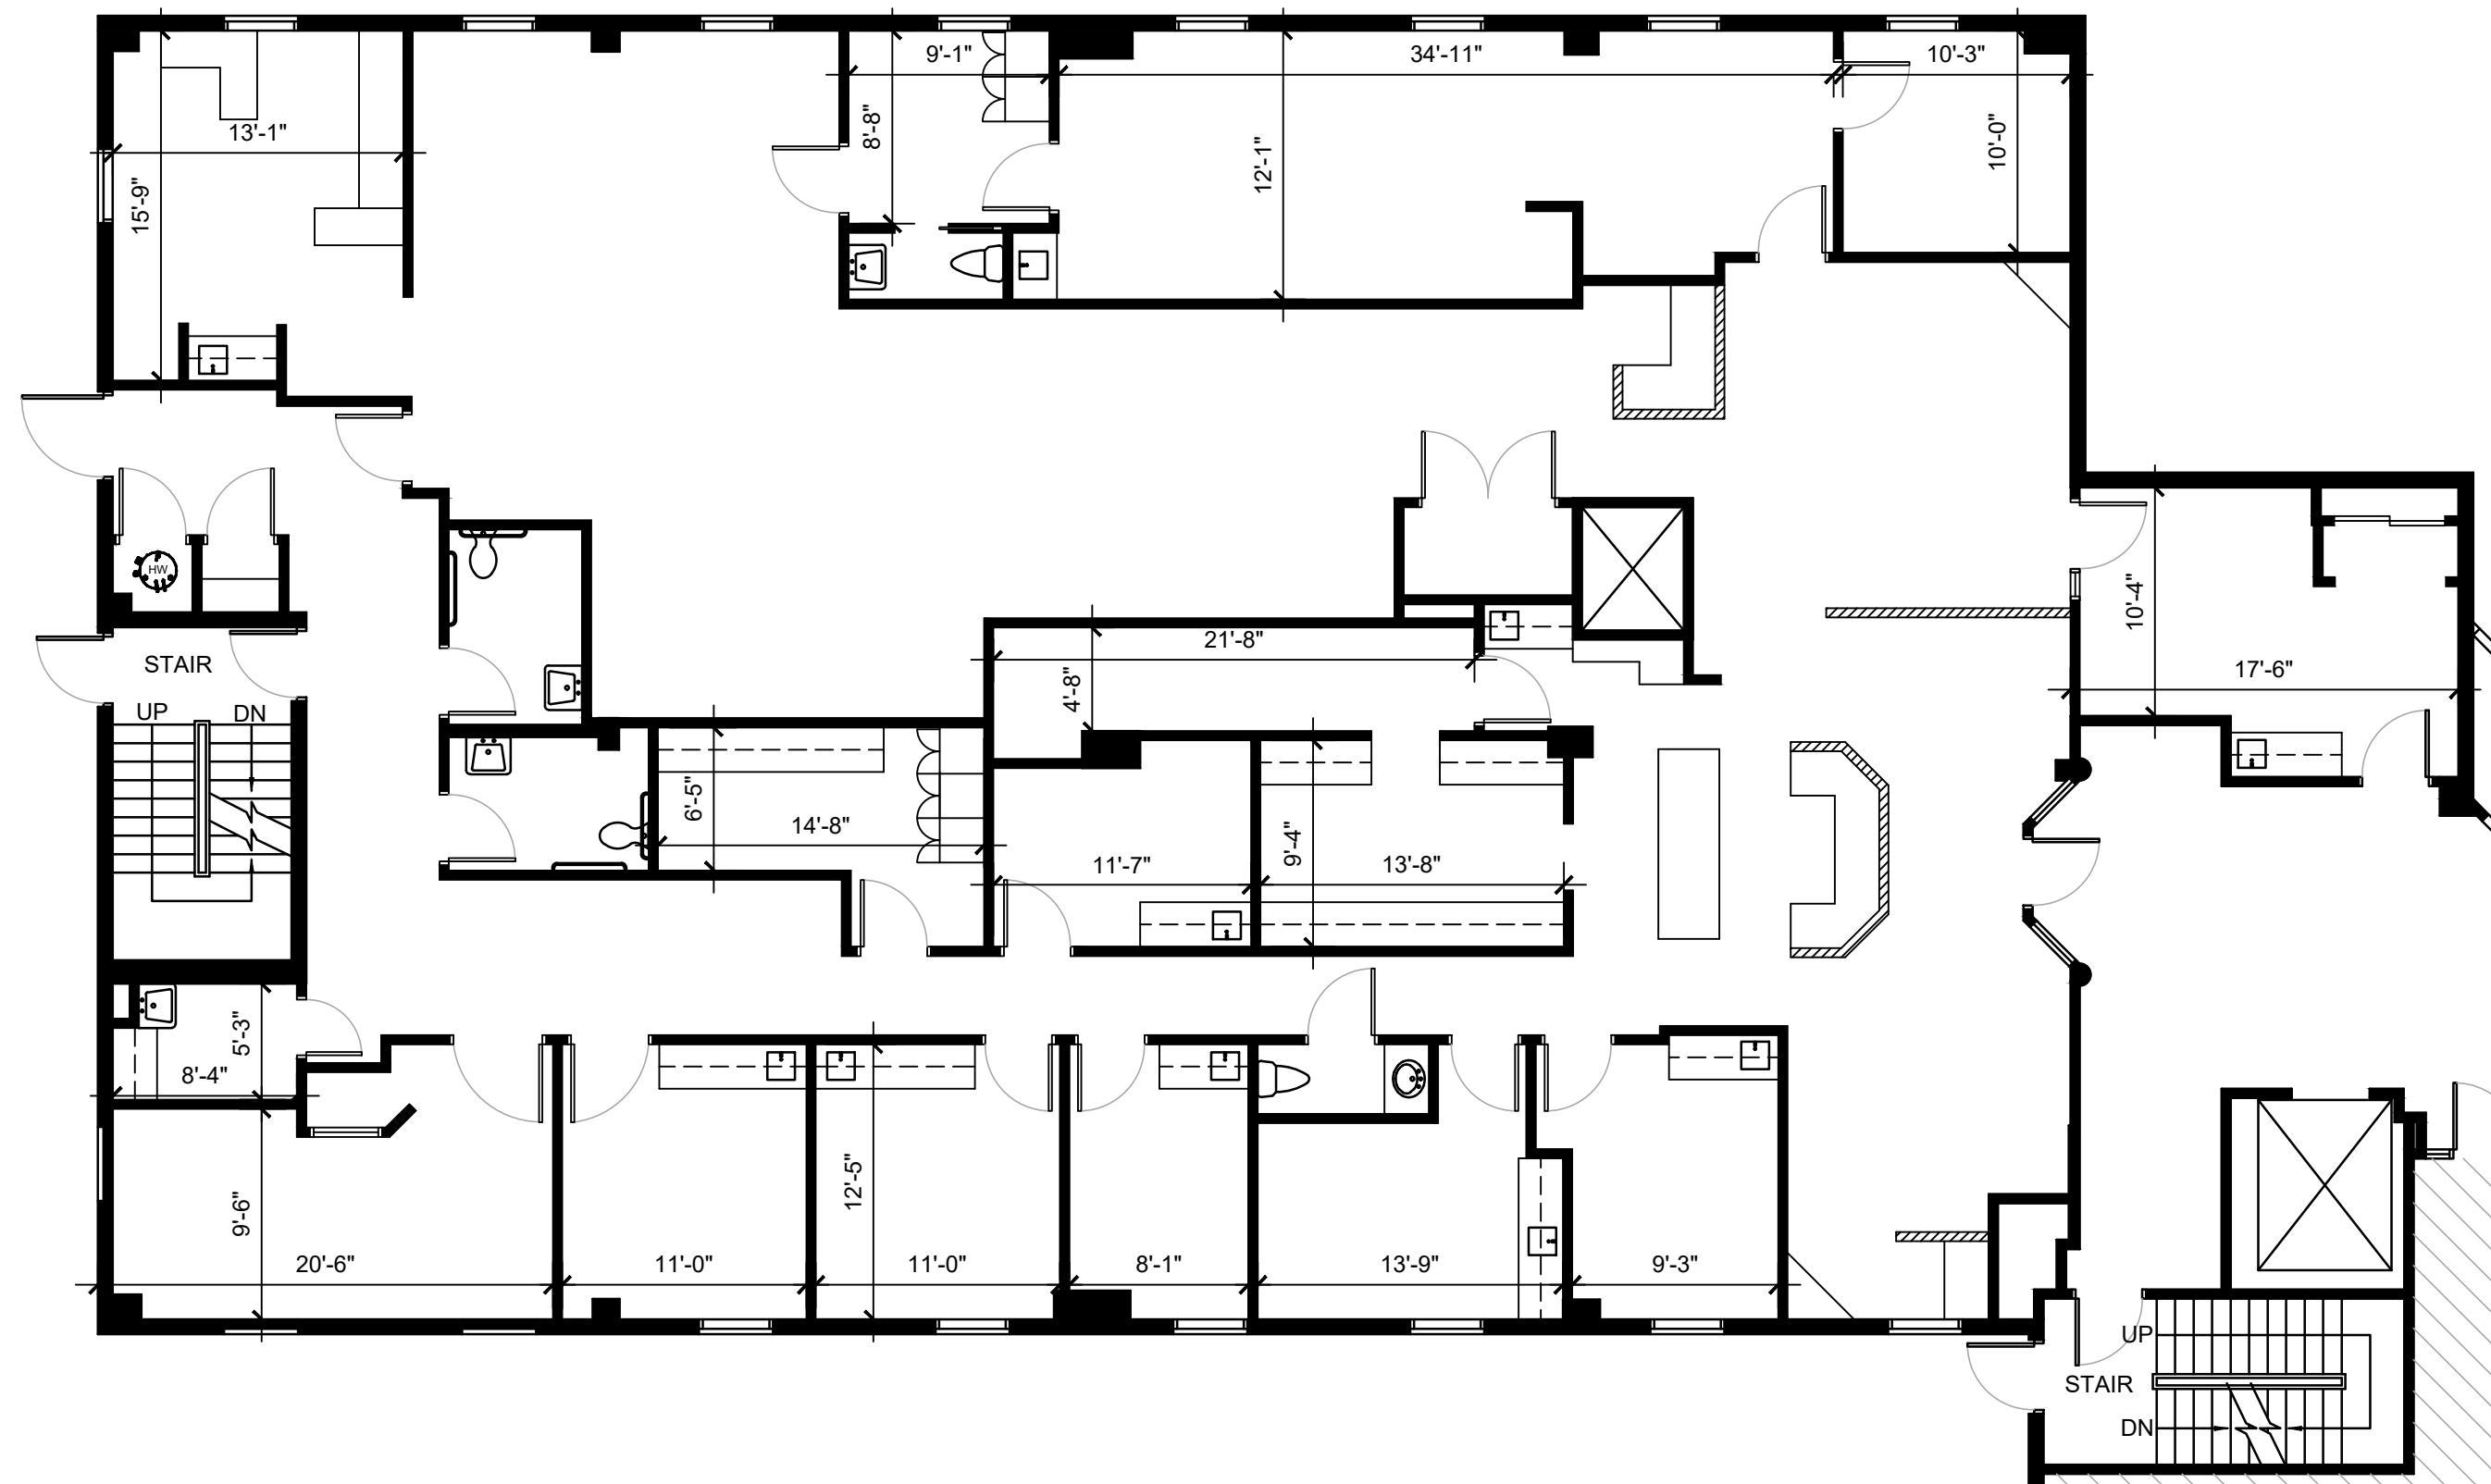

Record Drawing
Scale: 1/8" = 1'-0"

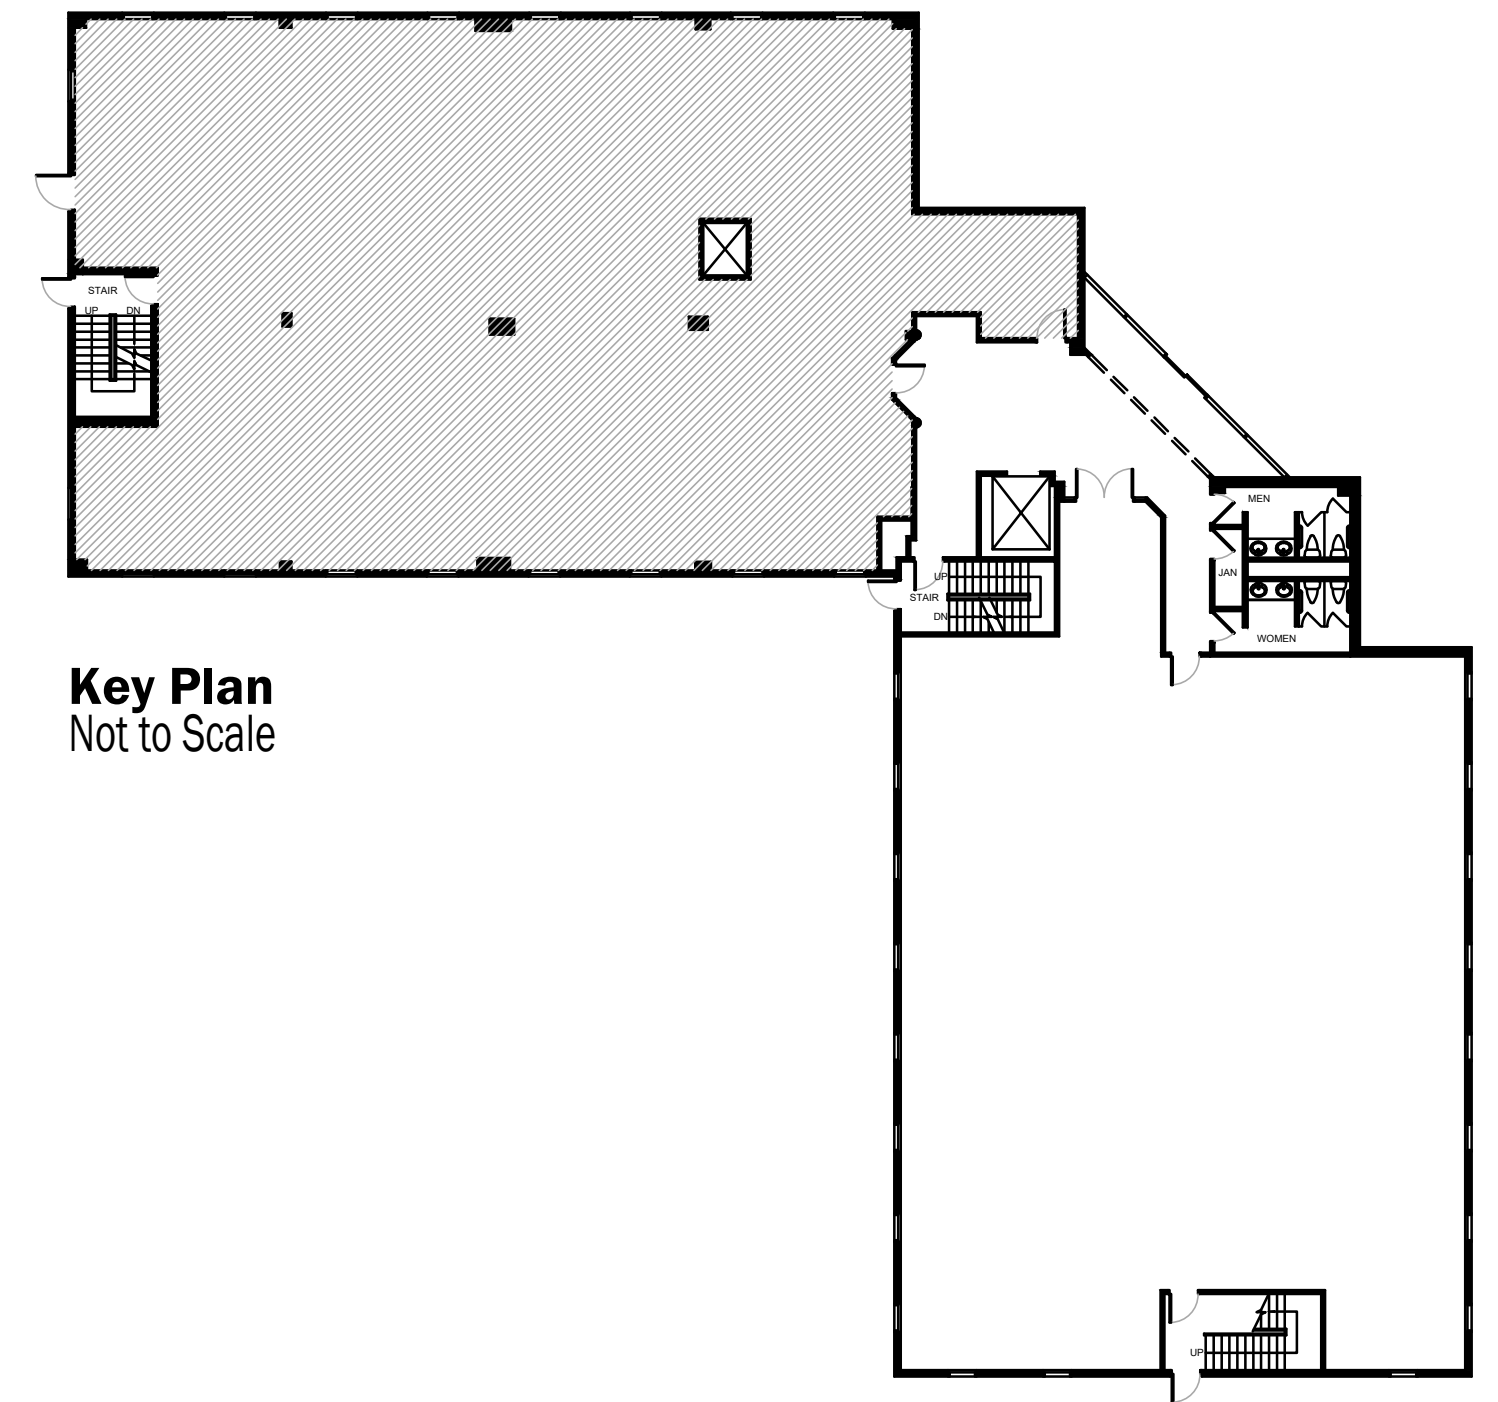

Key Plan
Not to Scale