



Veritas Real Estate Investments

One Greentree Centre, Marlton, NJ 08053
06/23/20

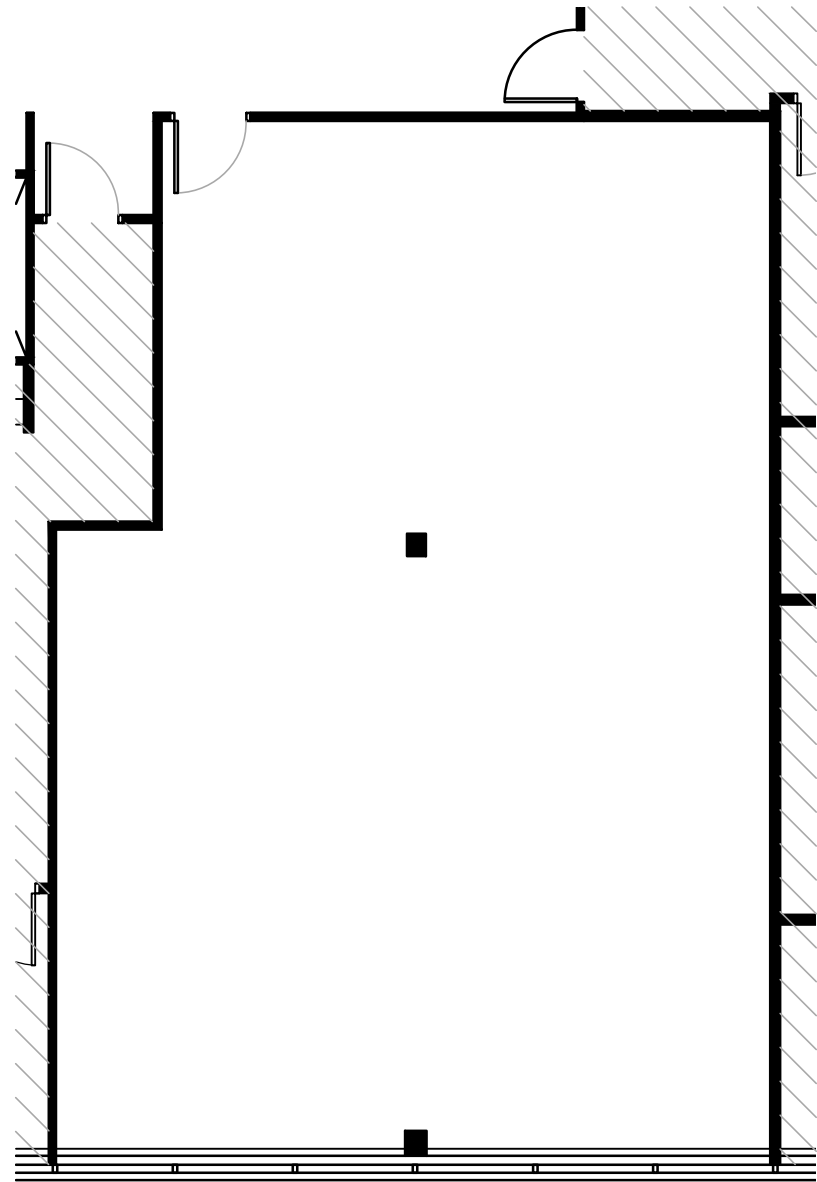

Record Drawing
Scale: 1/8" = 1'-0"

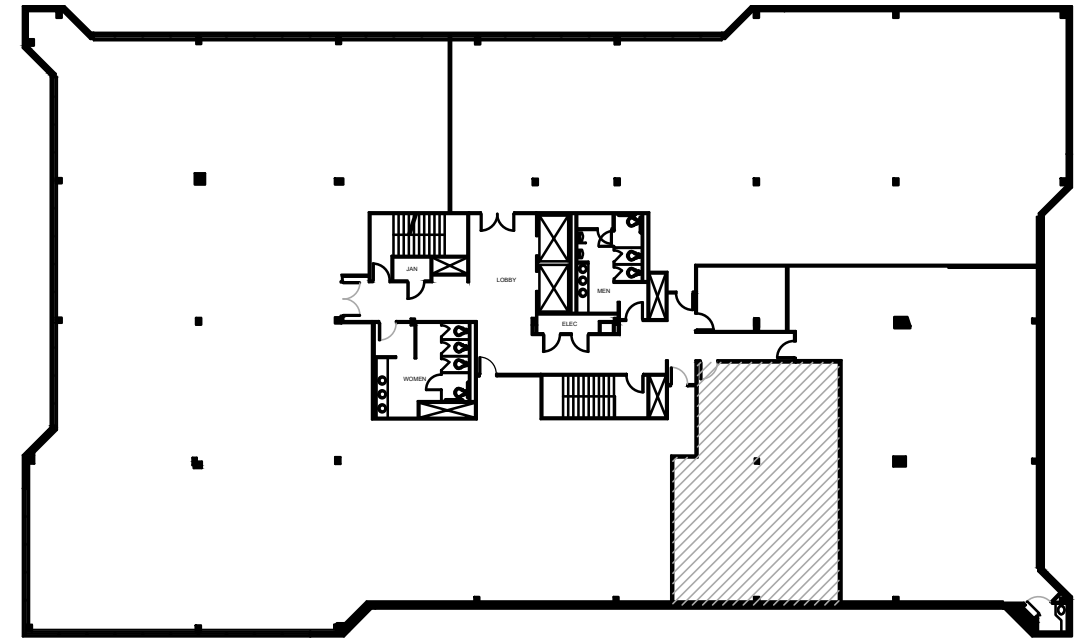

Key Plan
Not to Scale

PRELIMINARY - NOT FOR CONSTRUCTION
THIS DRAWING DOES NOT REFLECT THE GUIDELINES SET FORTH BY THE WORLD HEALTH ORGANIZATION AND
CENTER FOR DISEASE CONTROL OR OTHER GOVERNMENTAL AGENCY GUIDELINES RELATED TO COVID-19