


FLOOR PLAN
SCALE: 1/8" = 1'-0"

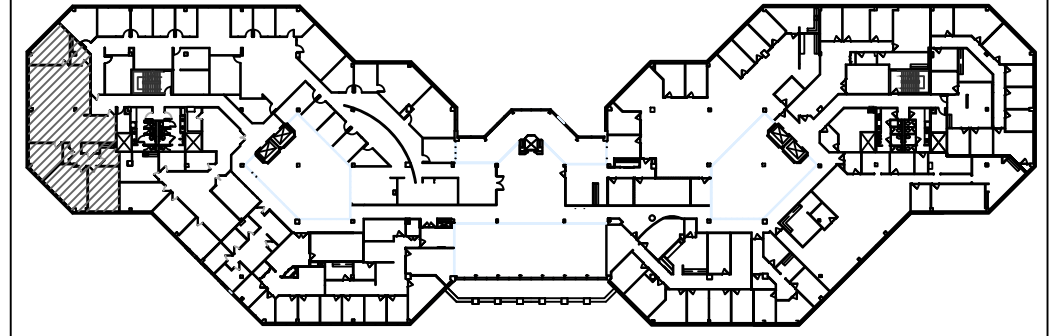

KEY PLAN - THIRD FLOOR
NOT TO SCALE



EXISTING CONDITIONS FOR:
SUITE 310
5 GREENTREE CENTRE
MARLTON, NJ 08053

RHJ ASSOCIATES, PC
ARCHITECTS · PLANNERS · DESIGNERS

KING OF PRUSSIA, PA 610.337.4555	MOUNT LAUREL, NJ 856.252.0040	PHILADELPHIA, PA 215.279.5845	WILMINGTON, DE 302.482.2269
-------------------------------------	----------------------------------	----------------------------------	--------------------------------

www.rhjassoc.com

DATE	11.21.2023
PROJECT NO.	2022-0102