




“As-Built” – B-12

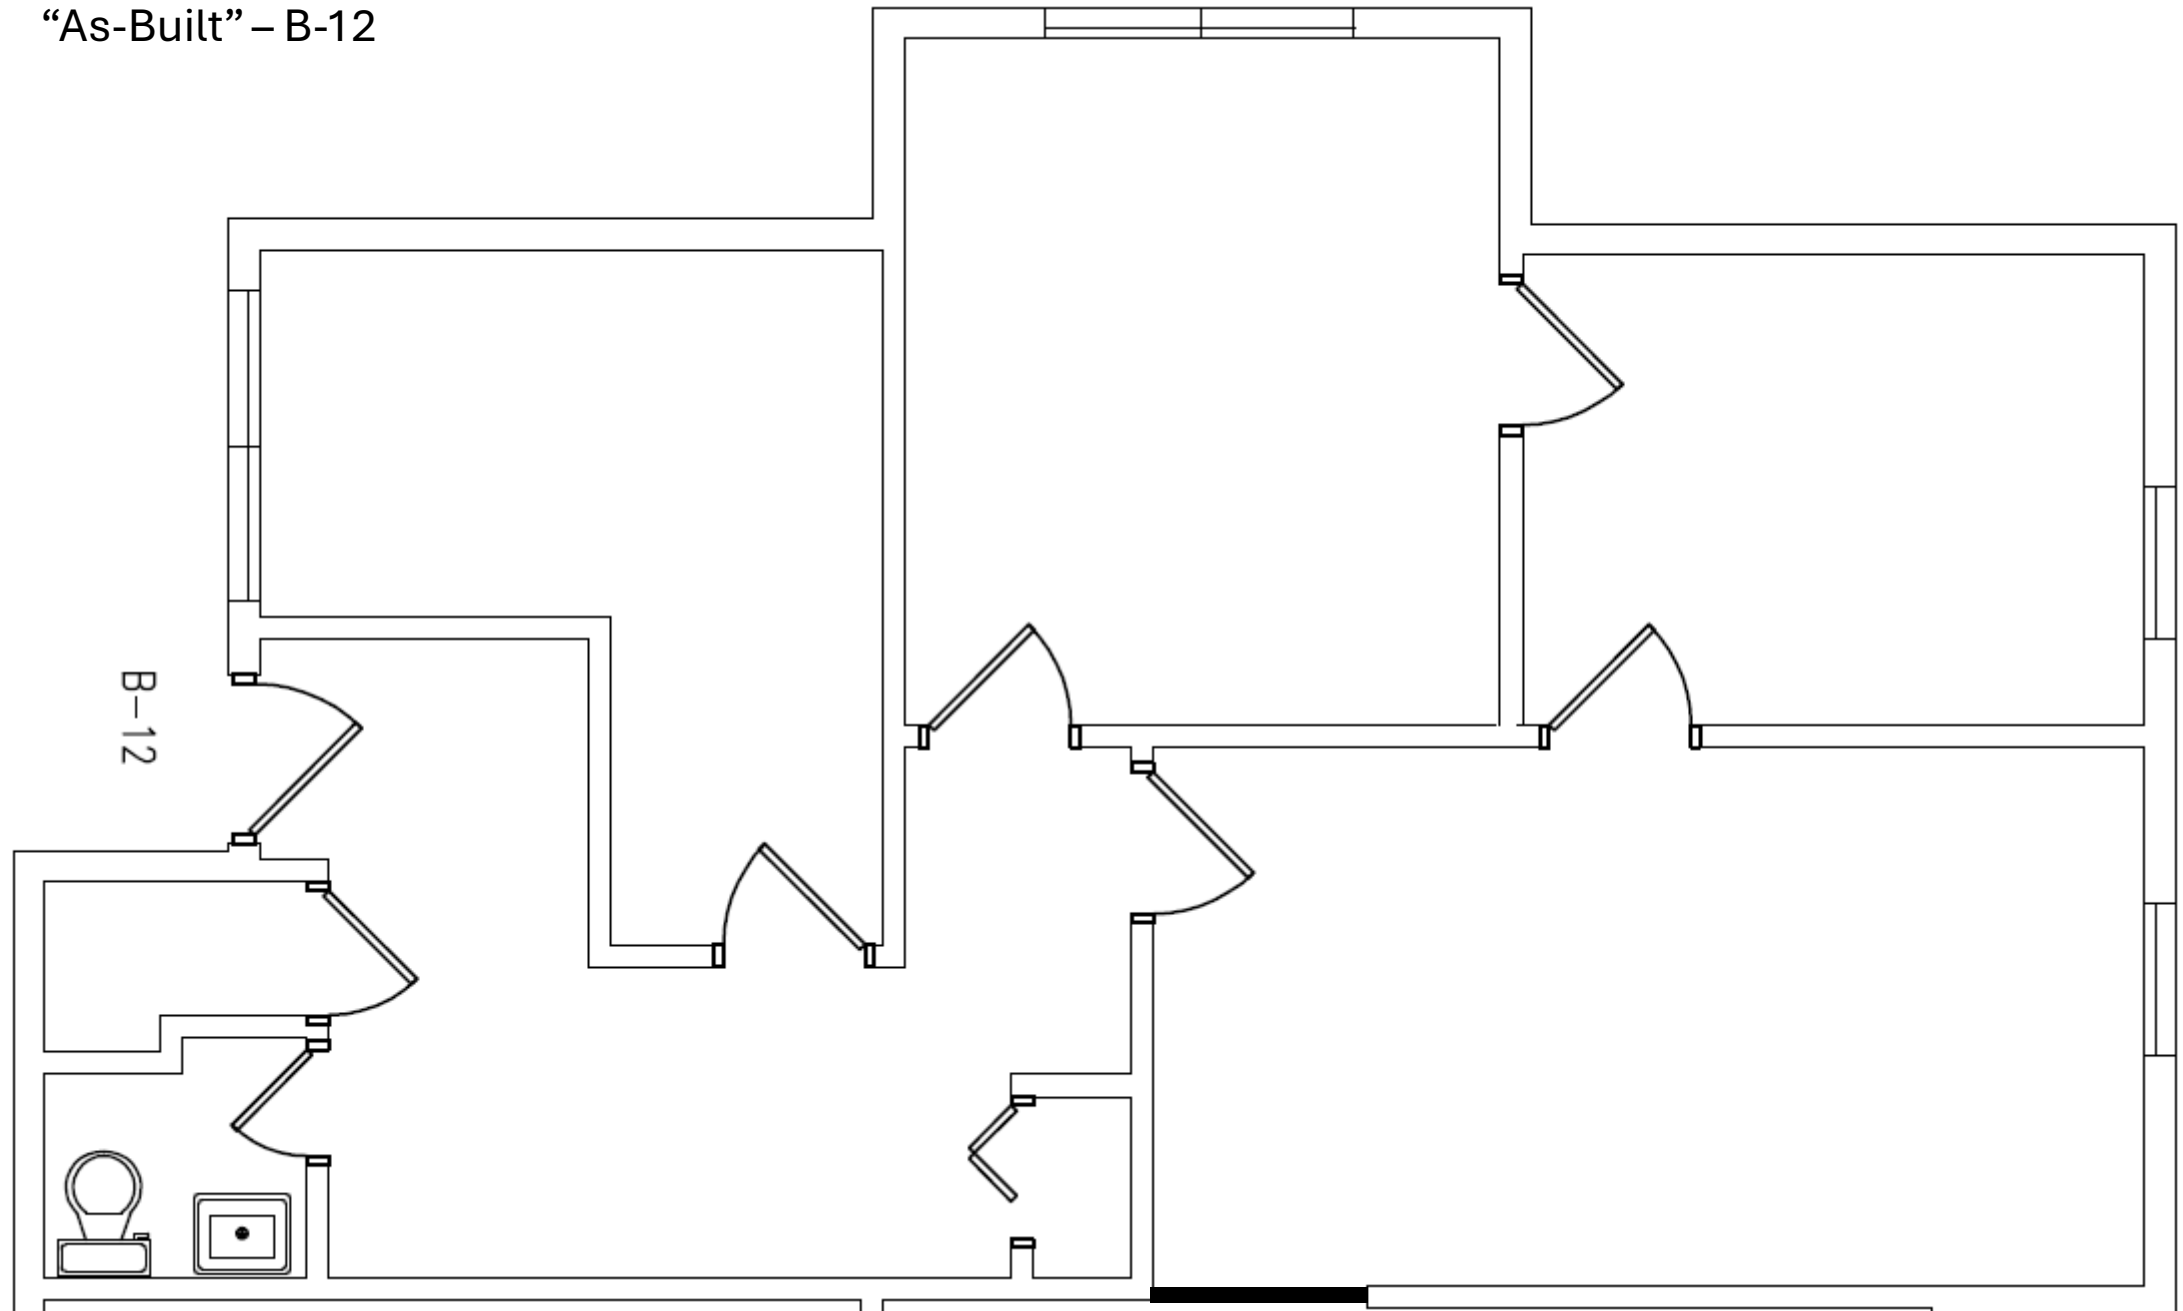

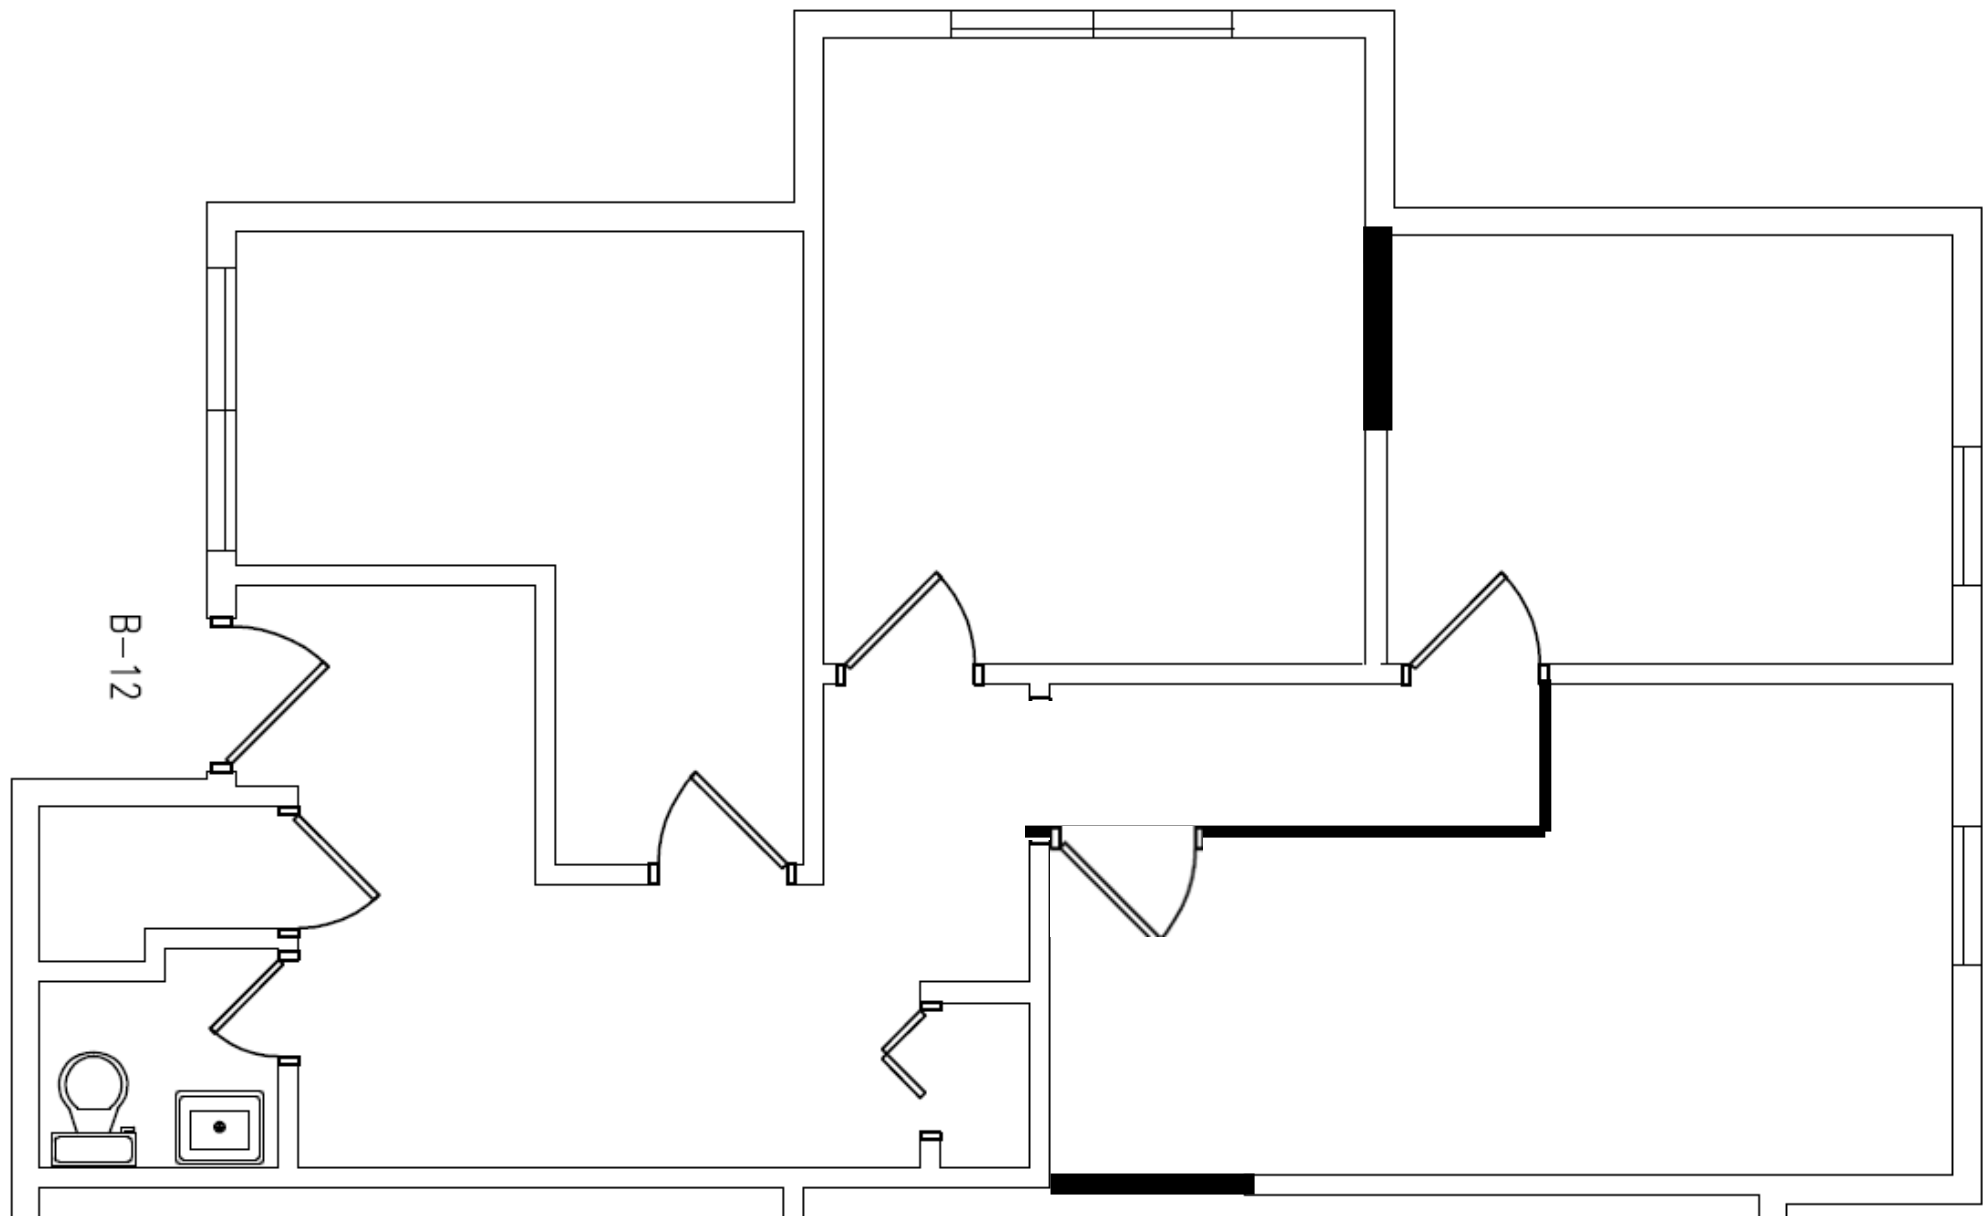

B-12

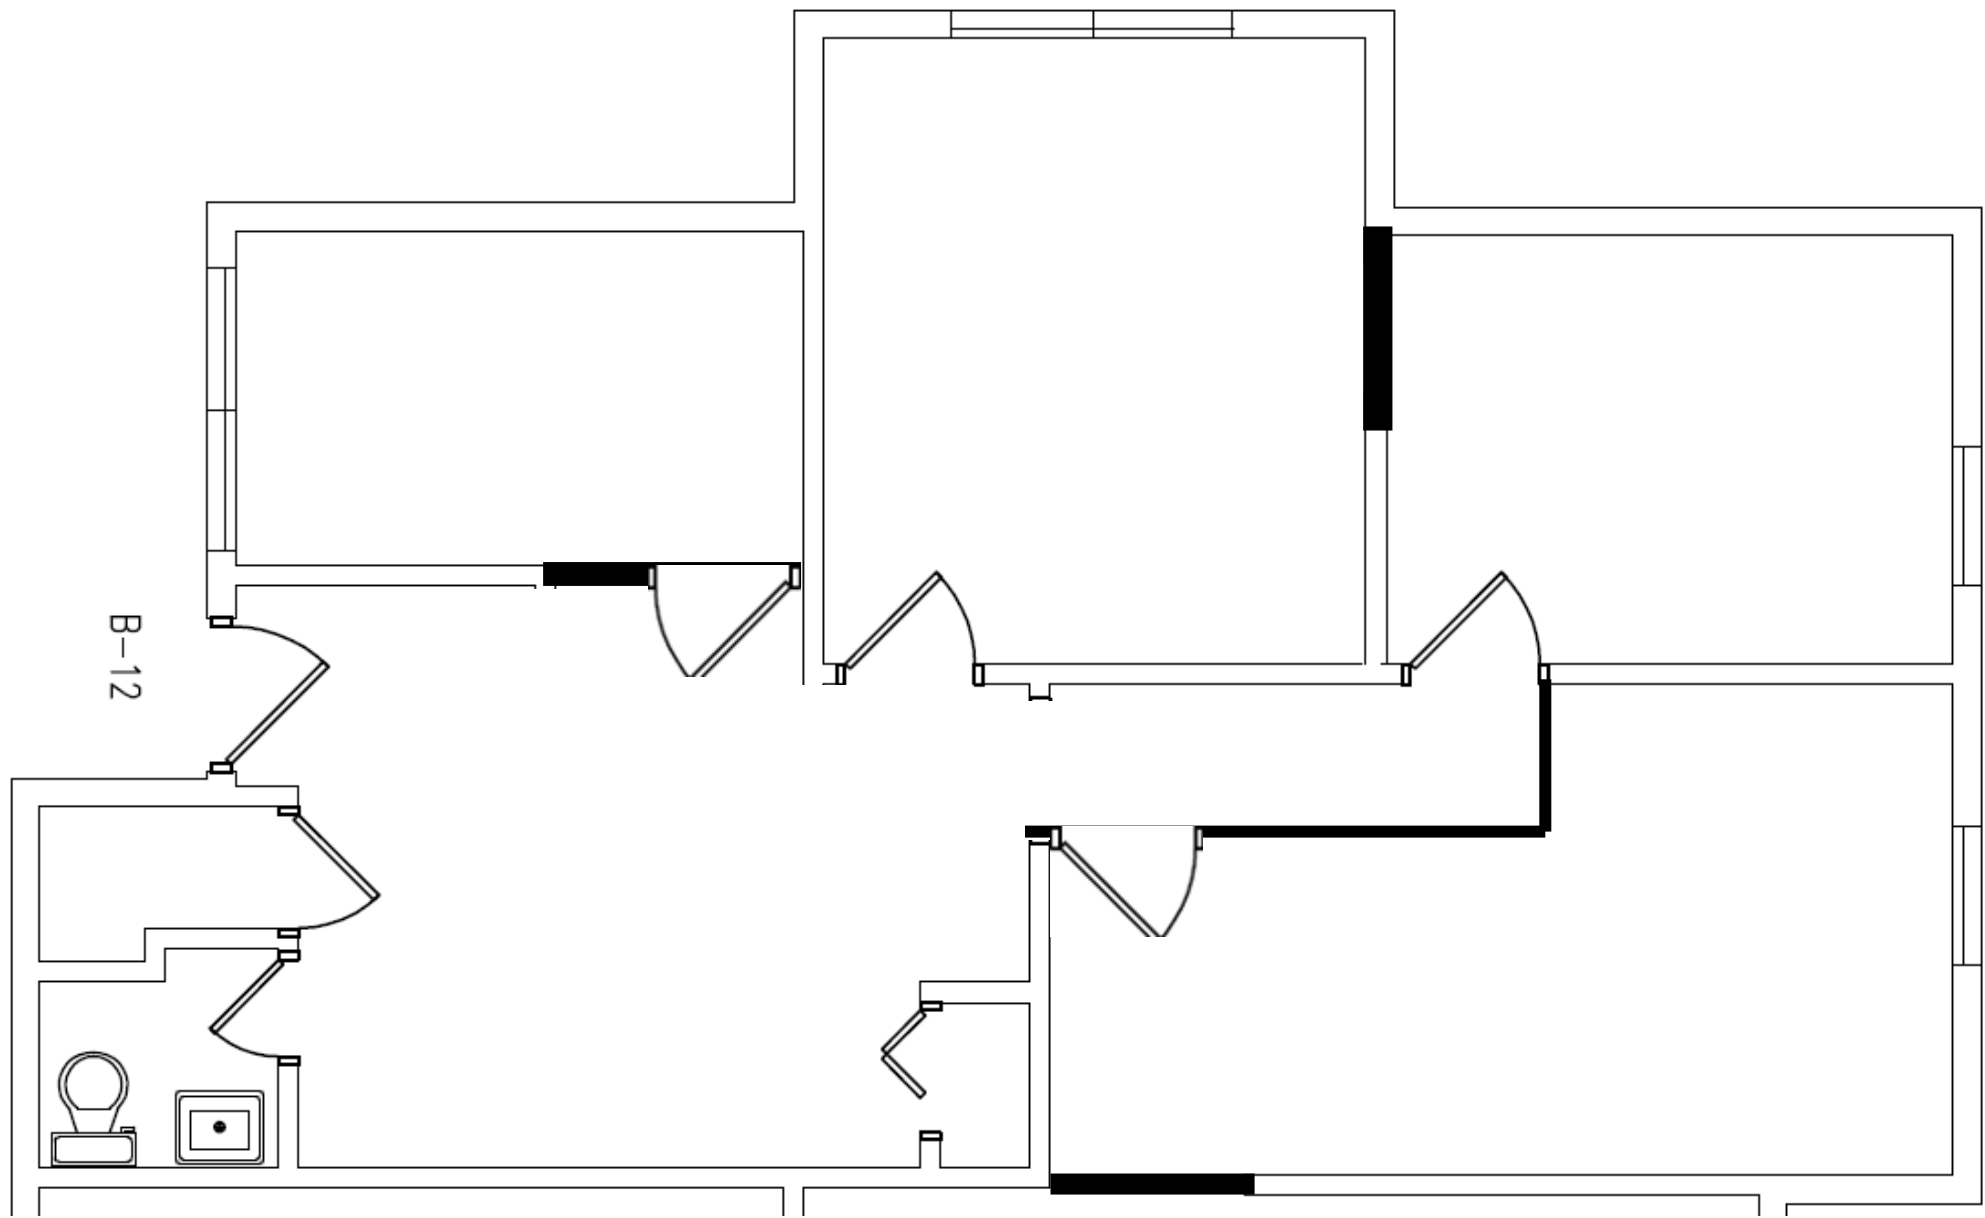

B-12