


Suite H-43

1,175 RSF

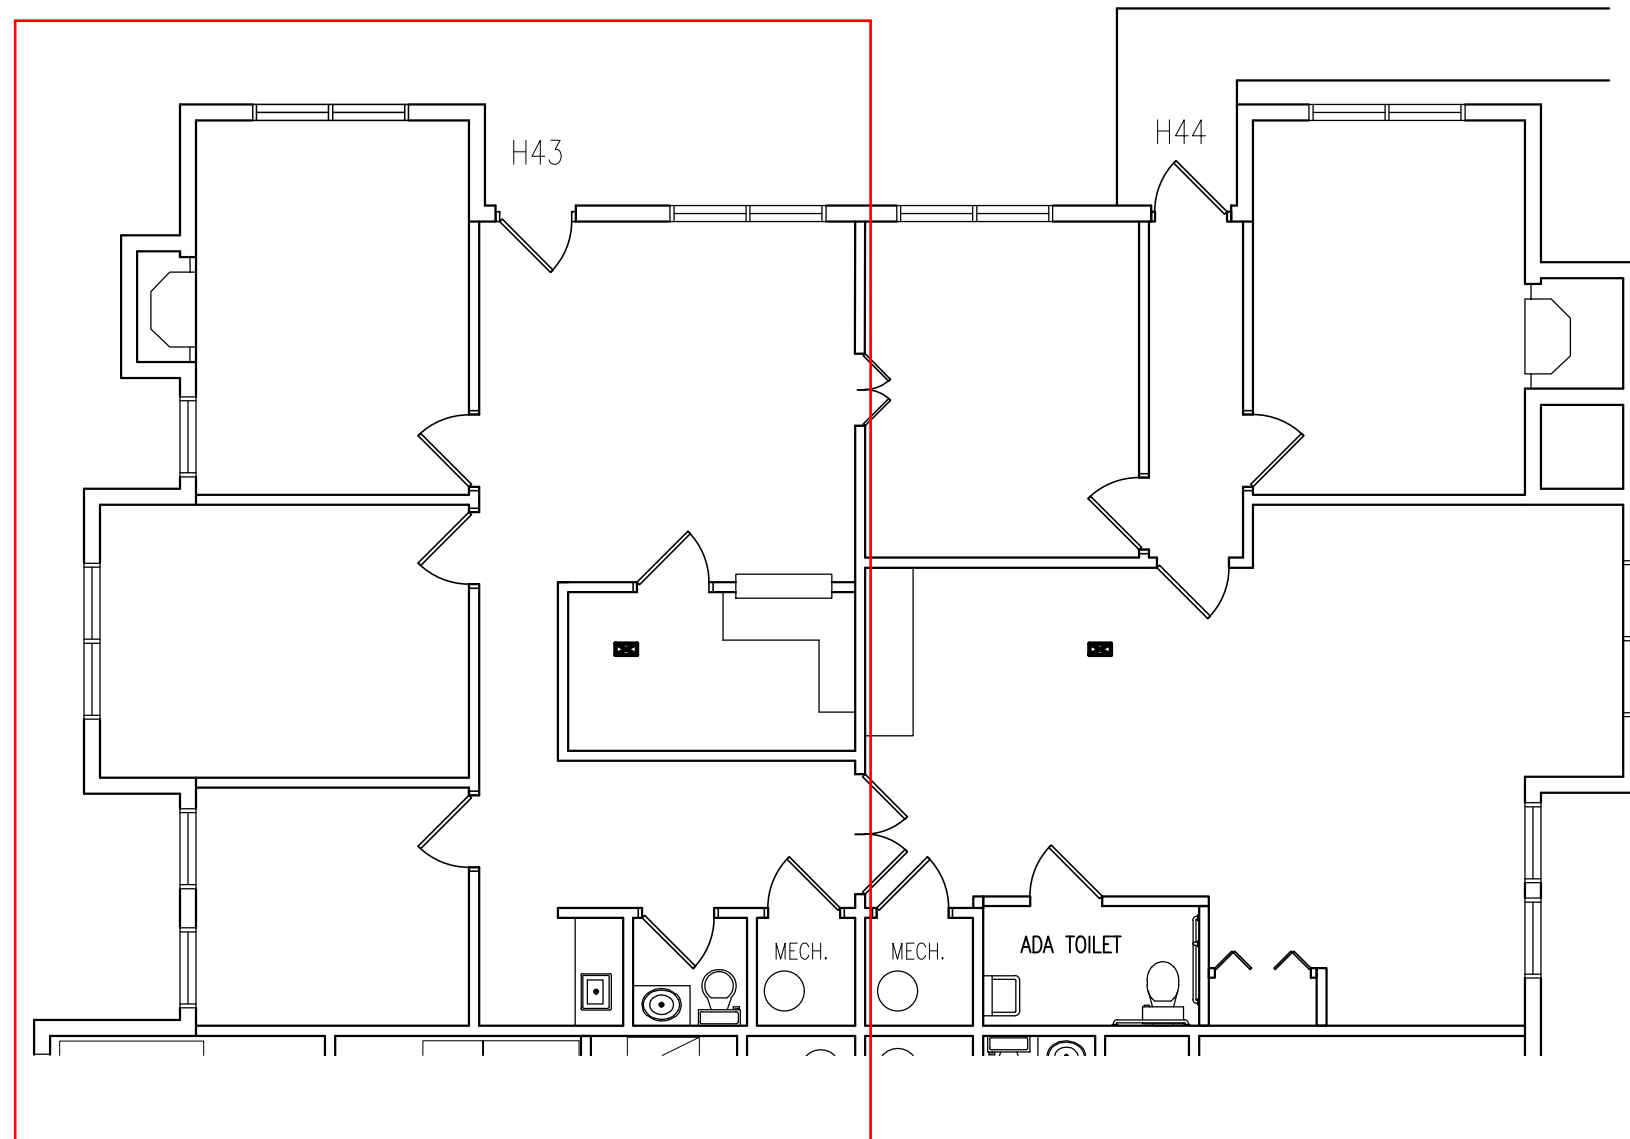

01	AS-BUILT PLAN
AB-1	1/8" = 1'-0"